

**WALLACE LAKE DRIVE (SECTION 1)**  
DISTANCE - Q TO GAS MAIN

STATION	DISTANCE
3+00	6.67'
4+00	7.00'
5+00	8.50'
6+00	9.00'
7+00	7.50'
8+00	8.00'
9+00	9.00'
10+00	9.33'
11+00	12.00'
12+00	12.00'
13+00	10.25'

**TEAL COURT**  
DISTANCE - Q TO GAS MAIN

STATION	DISTANCE
1+00	12.5'
1+50	22.0' RT 13.0' LT
1+75	25.0' RT 23.25' LT
2+00	33.5' RT 27.5' LT

**WALLACE LAKE DRIVE (SECTION 2)**  
DISTANCE - Q TO GAS MAIN

STATION	DISTANCE
1+00	16.33'
2+00	16.0'

**GOSHAWK COURT**  
DISTANCE - Q TO GAS MAIN

STATION	DISTANCE
1+00	3.25'
2+00	6.10'
3+00	6.00'
4+00	5.30'
4+80	35.00'

**WILLET COURT**  
DISTANCE - Q TO GAS MAIN

STATION	DISTANCE
1+00	11.25'
2+00	11.00'
3+00	10.67'
4+00	11.00'
5+00	9.50'

**WALLACE LAKE DRIVE SOUTH**  
DISTANCE - Q TO GAS MAIN

STATION	DISTANCE
1+00	5.0'
2+00	9.5'
3+00	9.5'
4+00	11.0'
5+00	11.5'
6+00	11.67'
7+00	12.0'
8+00	11.5'
9+00	11.5'
10+00	15.5'
11+00	16.33'

**NOTE:**  
ALL BEARINGS NOTED  
BASED ON COMPASS  
READING ONLY.


**CHUCKAR COURT**  
DISTANCE - Q TO GAS MAIN

STATION	DISTANCE
1+00	13.0'
2+00	12.0'
2+25	20.0'
2+50	32.0'
2+80	30.0' LT.
2+82	24.0' RT.

**NOTES:**

1. TRACER WIRE EXISTS THROUGHOUT ENTIRE SYSTEM.
2. ALL SERVICE LINES ARE 3/4" φ POLYETHYLENE.
3. ALL CENTERLINES NOTED ON PLANS REFER TO EXISTING PAINTED CENTERLINES ON ROADWAYS. CENTERLINE STATIONING BEGINS FROM CENTERLINE INTERSECTIONS.
4. THESE "AS-BUILT" DRAWINGS HAVE BEEN DEVELOPED FROM A COMPILATION OF THE FOLLOWING:
  - a) P. G. & E. "AS-BUILT" DRAWINGS
  - b) PACIFIC BELL "AS-BUILT" DRAWINGS
  - c) FIELD INSPECTOR DAILY REPORTS,
  - d) PHYSICAL IN FIELD VERIFICATION OF STEEL SERVICE RISER/VALVE LOCATIONS.
5. TRENCH LOCATIONS ARE APPROXIMATE ONLY AND SHOULD BE VERIFIED VIA TRACER WIRE PRIOR TO ANY EXCAVATION AS TO AVOID CONFLICTS. BEFORE DIGGING CONTACT THE FOLLOWING:  
 U.S.A. : 1-800-642-2444  
 W.U.U.A. : 1-800-424-3447  
 CAMPRO PROpane SERVICE : 1-209-466-4088
6. LOCATION OF SERVICE RISERS SHOWN ON THIS PLAN ARE RELATIVE TO FRONT PROPERTY CORNERS.

**JOINT TRENCH CONFIGURATIONS-TYPICAL**  
N. T. S.

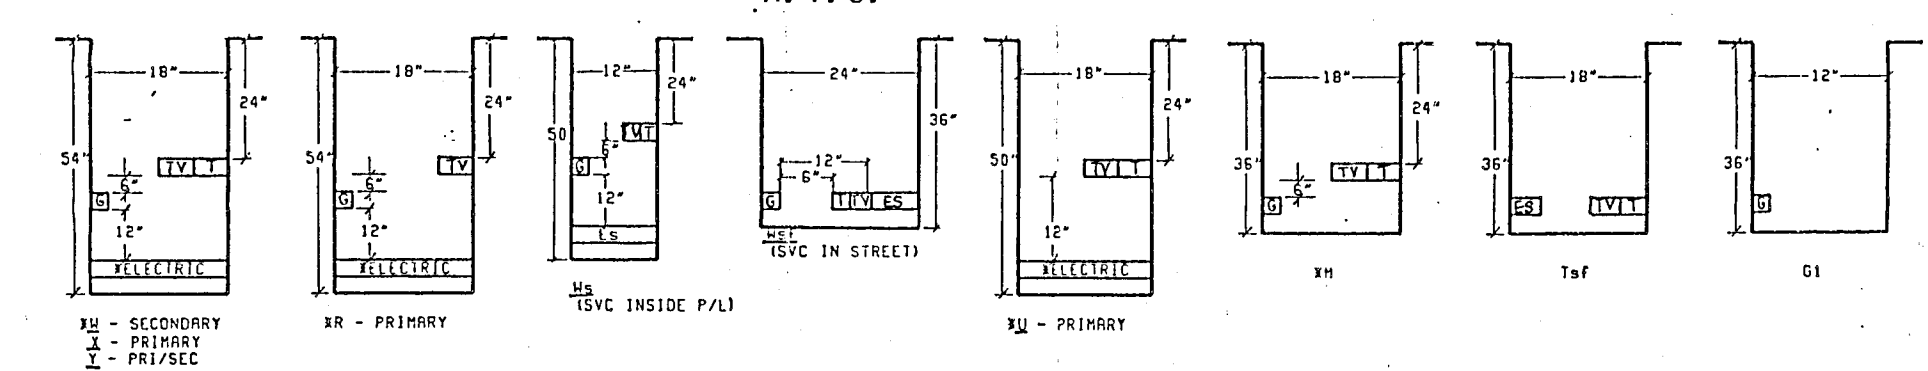

- LEGEND:**
- : GAS MAIN LINE
  - : SERVICE RISER W/ VALVE.
  - ④ : GAS MAIN - SIZE AS NOTED
  - 4+00 : CENTERLINE STATION
  - 15.0' : DISTANCE FROM SERVICE VALVE TO MAIN
  - : EXISTING PAINTED CENTERLINES ON ROADWAY.

**GAS SYSTEMS ENGINEERING**  
DESIGNER • CONTRACTOR • MAINTENANCE

P.O. BOX 28225, SACRAMENTO, CA 95828 (916) 486-1977

**PROPANE GAS SYSTEM DISTRIBUTION FACILITIES**  
WALLACE ESTATES UNIT 1

SHOWN T.R.C. DATE: 7-11-90  
 CHECKED: DATE: 02/22  
 APPROVED: SCALE: SHOWN  
 DWG NO: 0032

**WALLACE LAKE ESTATES**  
UNIT 1

**WEATHERBY REYNOLDS**  
CONSULTING ENGINEERS

208 PLEK ST., JACKSON, CA 95642 (209) 223-0381  
 (209) 734-1137 FAX # (209) 223-0716

SCALE 1" = 100'

WALLACE LAKE DRIVE (SECTION 2)  
DISTANCE - G TO GAS MAIN

STATION	DISTANCE
3+00	14.5'
4+00	12.0'
5+00	13.0'
6+00	12.5'
7+00	13.5'
8+00	13.25'
9+00	13.0'
10+00	12.0'

VERDIN COURT  
DISTANCE - G TO GAS MAIN

STATION	DISTANCE
1+00	12.5'
1+55	12.5'
2+00	11.0'
2+45	22.0' RT
2+54	33.0' LT
2+74	26.0' RT 23.0' LT

WALLACE LAKE DR. TO FUTURE  
DISTANCE - G TO GAS MAIN





STATION	DISTANCE
1+00	16.0'
2+00	20.0'
3+00	13.5'
4+00	14.25'
4+87	14.25'

CORMORANT DRIVE  
DISTANCE - G TO GAS MAIN

STATION	DISTANCE
1+00	12.5'
2+00	13.5'
3+00	12.0'
4+00	12.0'
5+00	12.0'
6+00	13.0'
7+00	11.0'
8+00	10.5'
9+00	12.5'
10+00	12.0'
10+45	14.3'
11+00	13.0'

TURNSTONE COURT  
DISTANCE - G TO GAS MAIN

STATION	DISTANCE
1+00	15.0'
2+00	14.5'
3+00	14.5'
4+00	13.5'
5+00	11.5'
6+00	11.0'
7+00	10.5'
8+00	13.0'
8+25	14.0'
8+70	23.0'
8+84	33.0' LT, 32.0' RT
9+00	37.0' LT, 38.0' RT
9+25	33.0' LT
9+34	25.0' RT

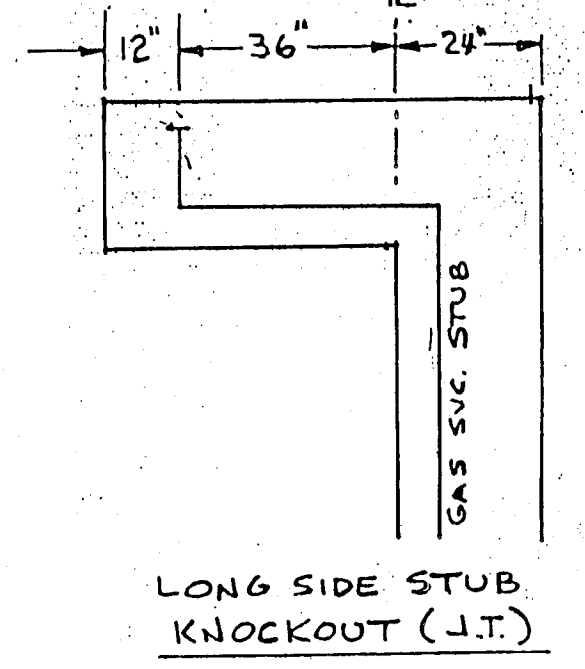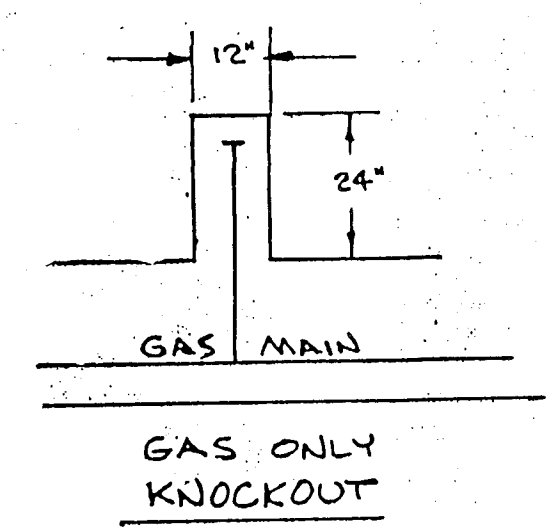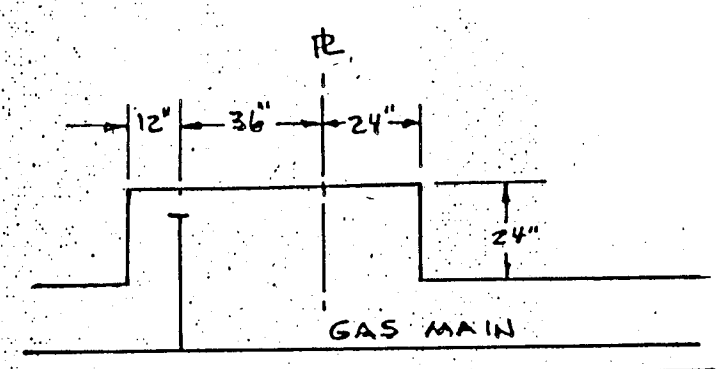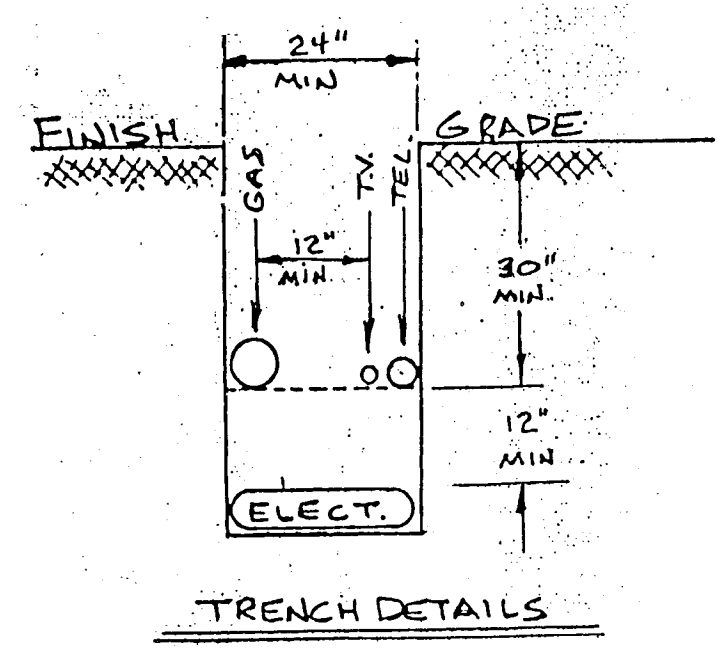

- NOTES:
- 1) SAND REQUIREMENTS: 4" UNDER & 6" OVER ALL GAS FACILITIES.
  - 2) ALL GAS STUB SERVICES SHALL BE 3/4" IPS (POLYETHYLENE)
  - 3) ALL WORK TO BE IN ACCORDANCE WITH P.E.C. STANDARDS AND SPEC'S.
  - 4) CONTRACTOR TO INSTALL CONDUIT XINGS ON MAIN & STUB SVC XINGS.
  - 5) CONTRACTOR TO COORDINATE ALL TRENCHING & INSTALLATION WITH P.E.C. REPRESENTATIVE.
  - 6) SEE "SPECIFIC CONDITIONS FOR GAS MAIN & SERVICE INSTALLATION WORK", FOR MATERIALS & VENDORS APPROVED LISTS.

- LEGEND:
- : GAS MAIN LINE
  - : SERVICE RISER W/ VALVE
  - 4" : GAS MAIN - SIZE AS NOTED
  - 4+60 : CENTERLINE STATION
  - 15.0' : DISTANCE FROM SERVICE VALVE TO MAIN
  - : EXISTING PAINTED CENTERLINES ON ROADWAY

GAS SYSTEMS ENGINEERING  
200 BOY FETIS, SACRAMENTO, CA 95811  
PROANE GAS SYSTEM  
DISTRIBUTION FACILITIES  
WALLACE ESTATES NO. 1  
DRAWN BY DATE 7-11-90  
CHECKED JOB NO. 0032  
APPROVED SCALE SHOWN  
DWG NO. 0032-

WALLACE LAKE ESTATES  
UNIT 1  
**WEATHERBY REYNOLDS**  
CONSULTING ENGINEERS  
206 PEEK ST., JACKSON, CA 95642 (209) 223-0381  
(209) 764-1137 FAX # (209) 223-0716  
D-3829